


APPENDIX A-2

This drawing is the property of In+Form Design, Inc. and is not to be reproduced, copied, or used in any way without the written consent of In+Form Design, Inc. The user of this drawing warrants that it is for the use and purpose intended by the user. The user of this drawing warrants that it is for the use and purpose intended by the user. The user of this drawing warrants that it is for the use and purpose intended by the user.

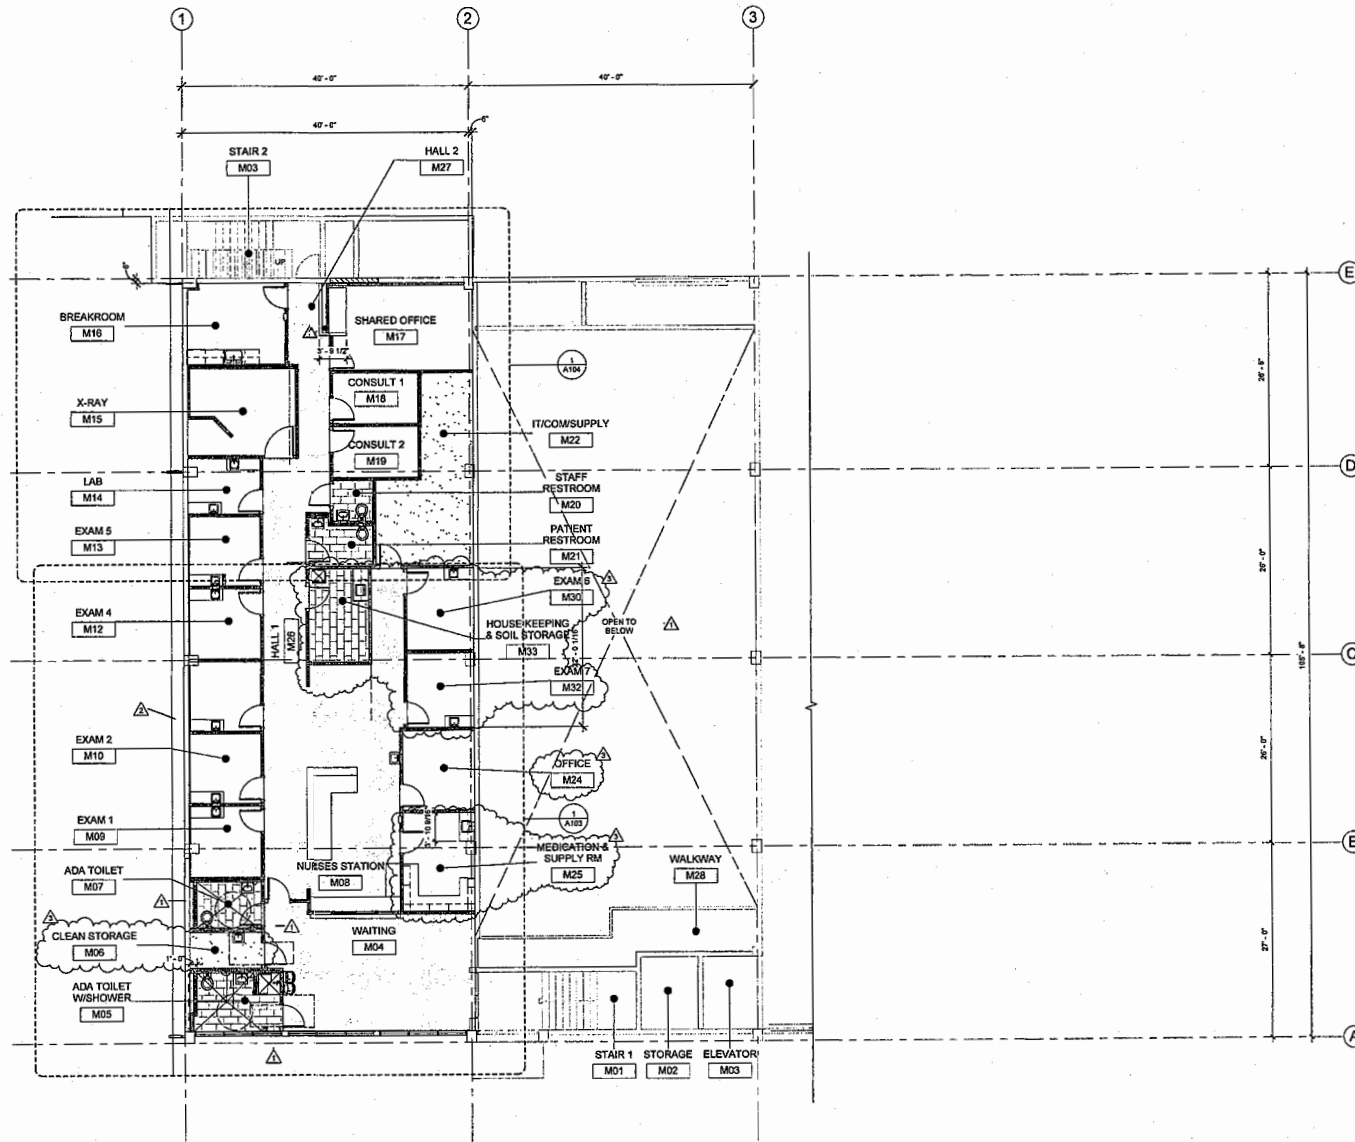

1 MEZZANINE FLOOR PLAN
 1/8" = 1'-0"



NOTES:
 1) ENTIRE EXISTING MET. STUD WALL ALONG GRIDLINE "1" SHALL RECEIVE NEW BATT INSULATION BETWEEN STUDS AND A NEW LAYER OF 5/8" TYPE "X" GYP SO @ THE MEZZANINE SIDE OF THE WALL.
 2) EXISTING WALL (REMOVE GYP. BOARD ON TENANT SIDE AS REQUIRED). INSTALL BATT INSULATION IN EXISTING FRAMING. INSTALL NEW 5/8" TYPE "X" GYP SO OVER EXISTING FRAMING ON TENANT SIDE AND PAINT AS SCHEDULED.
 3) NEW WALL

WALL LEGEND
 [Pattern] = NEW CMU WALL INFILL (MATCH EXISTING)
 [Pattern] = EXISTING WALL TO REMAIN
 [Pattern] = EXISTING WALL (REMOVE GYP. BOARD ON TENANT SIDE AS REQUIRED). INSTALL BATT INSULATION IN EXISTING FRAMING. INSTALL NEW 5/8" TYPE "X" GYP SO OVER EXISTING FRAMING ON TENANT SIDE AND PAINT AS SCHEDULED.
 [Pattern] = NEW WALL

ZONING PLAN REVIEW
 By: BA REL
 Date: 12/11/2019

PALEKANA PERMITS
 THIRD PARTY CERTIFICATION
☒ BUILDING CODE ☒ ELECTRICAL CODE
☒ MECHANICAL CODE ☒ RESIDENTIAL CODE
☒ STRUCTURAL/POUR (EXCEPT FOR CHALLENGE)

In+Form Design, Inc.
 1547 Kapaemahu Blvd, Suite 401
 Honolulu, HI 96814
 Telephone: (808) 945-3876
 Fax: (808) 945-8728

Architect of Record
 [Professional Seal]
 This work was prepared by me or under my supervision, and certification of this project will be under my observation.
 Signature: _____ Expiration Date of the License: 12/31/2020

H4 URGENT CARE - KIWILI
 TENANT IMPROVEMENTS
 431 KIWILI STREET, HONOLULU, HAWAII
 TMC 15-002-09

NO.	DATE	DESCRIPTION
1	11/19/19	Issue Permit Rev. (Addendum 1)
2	12/11/19	COVID-19 Revisions
3	12/22/19	COVID-19 Revisions
4	1/28/20	COVID-19 Revisions

Drawn By: JPD
 Scale: AS INDICATED
 Date: 10/15/2019
 Job No: 18-007-00
 Sheet Title: MEZZANINE FLOOR PLAN
 Sheet Number: A101

REVISED PRINT

[illegible]

H4 URGENT CARE - KUWILI
TENANT IMPROVEMENTS
431 KUWILI STREET, HONOLULU, HAWAII
TAK: 1-5-009:09

In+Form Design, Inc.



This work was prepared by me or under my supervision, and construction of this project will be under my observation.

Signature: Shane Jones Expiration Date of this License: 4/30/2022

KEY	DESCRIPTION	KEYNOTES
00	(E) CONCRETE COLUMN, TYP.	
000	LAVATORY (SEE MECH. DRAWINGS)	
007	PASS THROUGH WINDOW	
008	COUNTERTOP	
010	BASE CABINET W/ COUNTERTOP	
143	SEM-RECESSED ALUM FIRE EXTINGUISHER CABINET	
444	WATER COOLER W/ WATER BOTTLE FILLING STATION, (SEE MECH DRAWINGS)	

☐ EXTENDING CODE ☐ TELEPHONE CODE
☐ MEDICAL CODE ☐ IDENTIFICATION CODE
☐ SPECIALTY CODE ☐ SPECIALTY FULLY DEVELOPED

NOTES:

1) ALL OFFICE FURNITURE SHALL BE OWNED FURNISHED - OWNER INSTALLED UNLESS NOTED OTHERWISE


2) ALL FLOOR SLOPES SHALL BE 1/4" : 1'-0" MAX

NOTES:
1.) ENTIRE EXISTING MET. STUD WALL ALONG GRIDLINE "2" SHALL RECEIVE NEW BATT INSULATION BETWEEN STUDS AND A NEW LAYER OF 5/8" TYPE "X" GYP BD @ THE MEZZANINE SIDE OF THE WALL.

WALL LEGEND

NEW CURB WALL INFILL (MATCH EXISTING)
SEE DET. 13A401

■ EXISTING WALL TO REMAIN
■ EXISTING WALL (REMOVE GYP. BOARD ON TENANT SIDE AS REQUIRED, INSTALL BATT INSULATION IN EXISTING FRAMING, INSTALL NEW 3/4" TYPE "X" GYP. BD OVER EXISTING FRAMING ON TENANT SIDE AND PAINT AS SCHEDULED)
■ NEW WALL

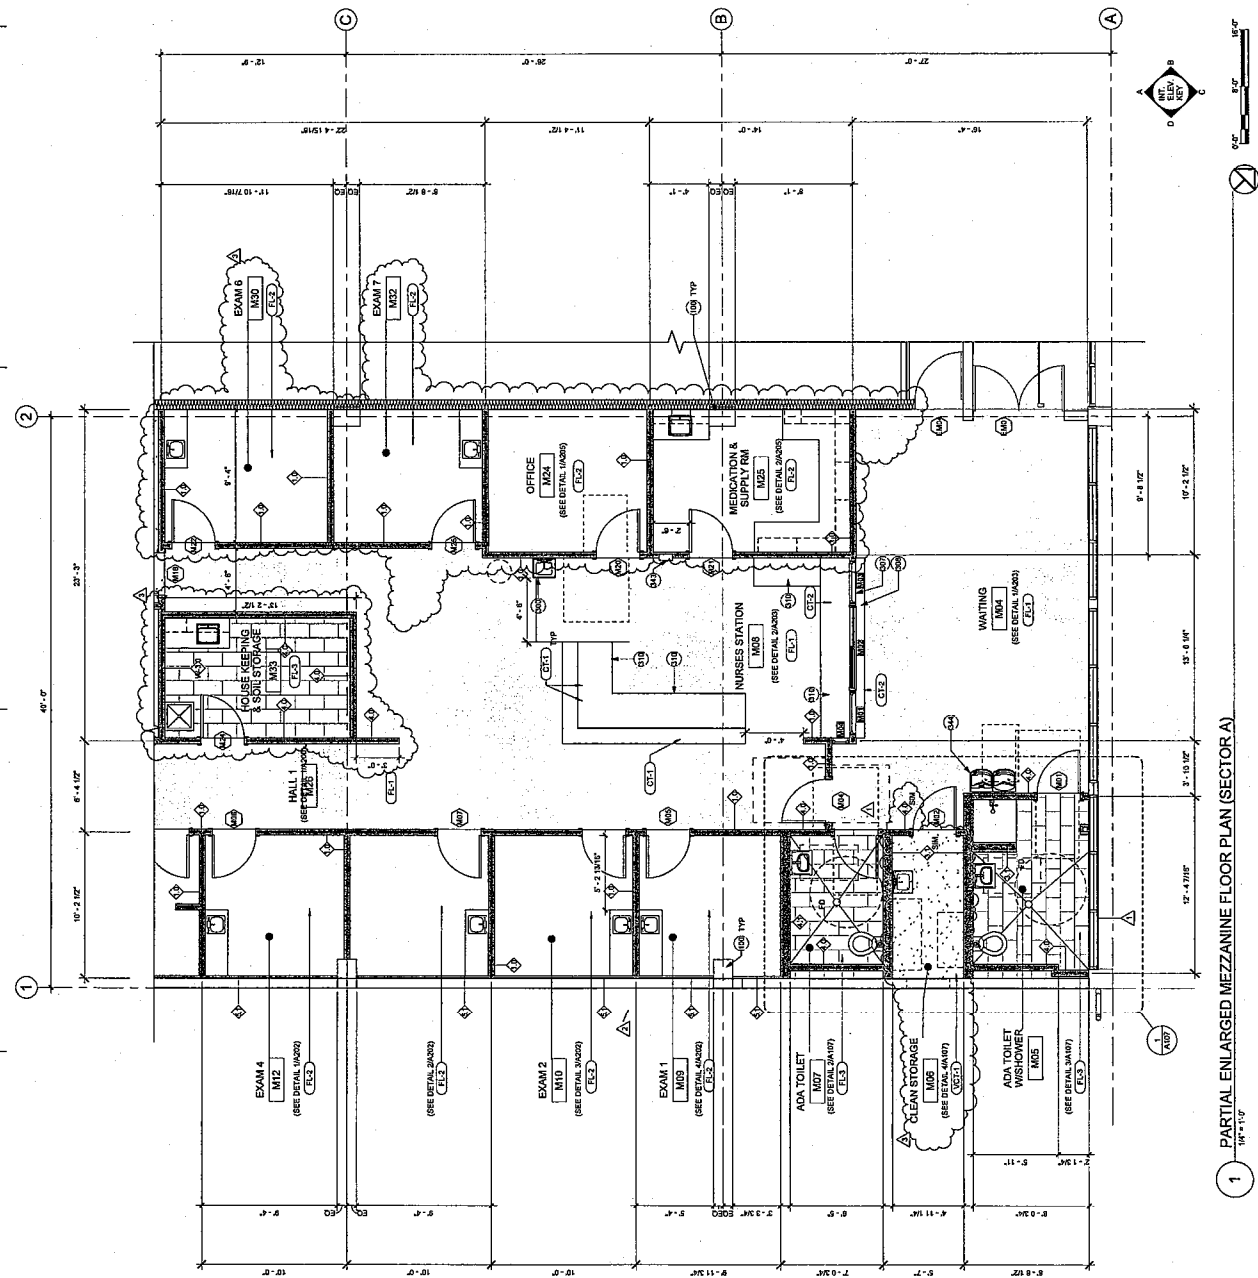

1 PARTIAL ENLARGED MEZZANINE FLOOR PLAN (SECTOR A)

1 PARTIAL ENLARGED MEZZANINE FLOOR PLAN (SECTOR B)

1/8" = 1'-0"

NOTES:
1) ALL OFFICE FURNITURE SHALL BE OWNER FURNISHED - OWNER INSTALLED UNLESS NOTED OTHERWISE.
2) ALL FLOOR SLOPES SHALL BE 1/4" : 1'-0" MAX.

NOTES:
1) ALL OFFICE FURNITURE SHALL BE OWNER FURNISHED - OWNER INSTALLED UNLESS NOTED OTHERWISE.
2) ALL FLOOR SLOPES SHALL BE 1/4" : 1'-0" MAX.

LEGEND:
NEW CONSTRUCTION
EXISTING CONSTRUCTION
DEMOLITION
MECHANICAL ROOM
ELECTRICAL ROOM
PLUMBING ROOM
TYPICAL SUPPLY
TYPICAL DRAIN

KEY	DESCRIPTION
100	(E) CONCRETE COLUMN, TYP.
310	BASE CABINET W/ COUNTERTOP
343	SEMI-RECESSED ALUM FIRE EXTINGUISHER CABINET
358	WALL MOUNTED CABINET ABOVE

In-Form Design, Inc.
1547 Kalia Road, Suite 401
Honolulu, HI 96814
Telephone: (808) 944-3076
Fax: (808) 944-3078

Architect of Record
PROJECT NO. 15-009-09
DATE: 10/15/2019
SHEET NO. 19-007-00

TENANT IMPROVEMENTS
431 KUALA STREET, HONOLULU, HAWAII

NO.	DATE	DESCRIPTION
1	10/15/2019	REVISED
2	10/15/2019	REVISED
3	10/15/2019	REVISED
4	10/15/2019	REVISED

